




B3階 平面図
1 : 300

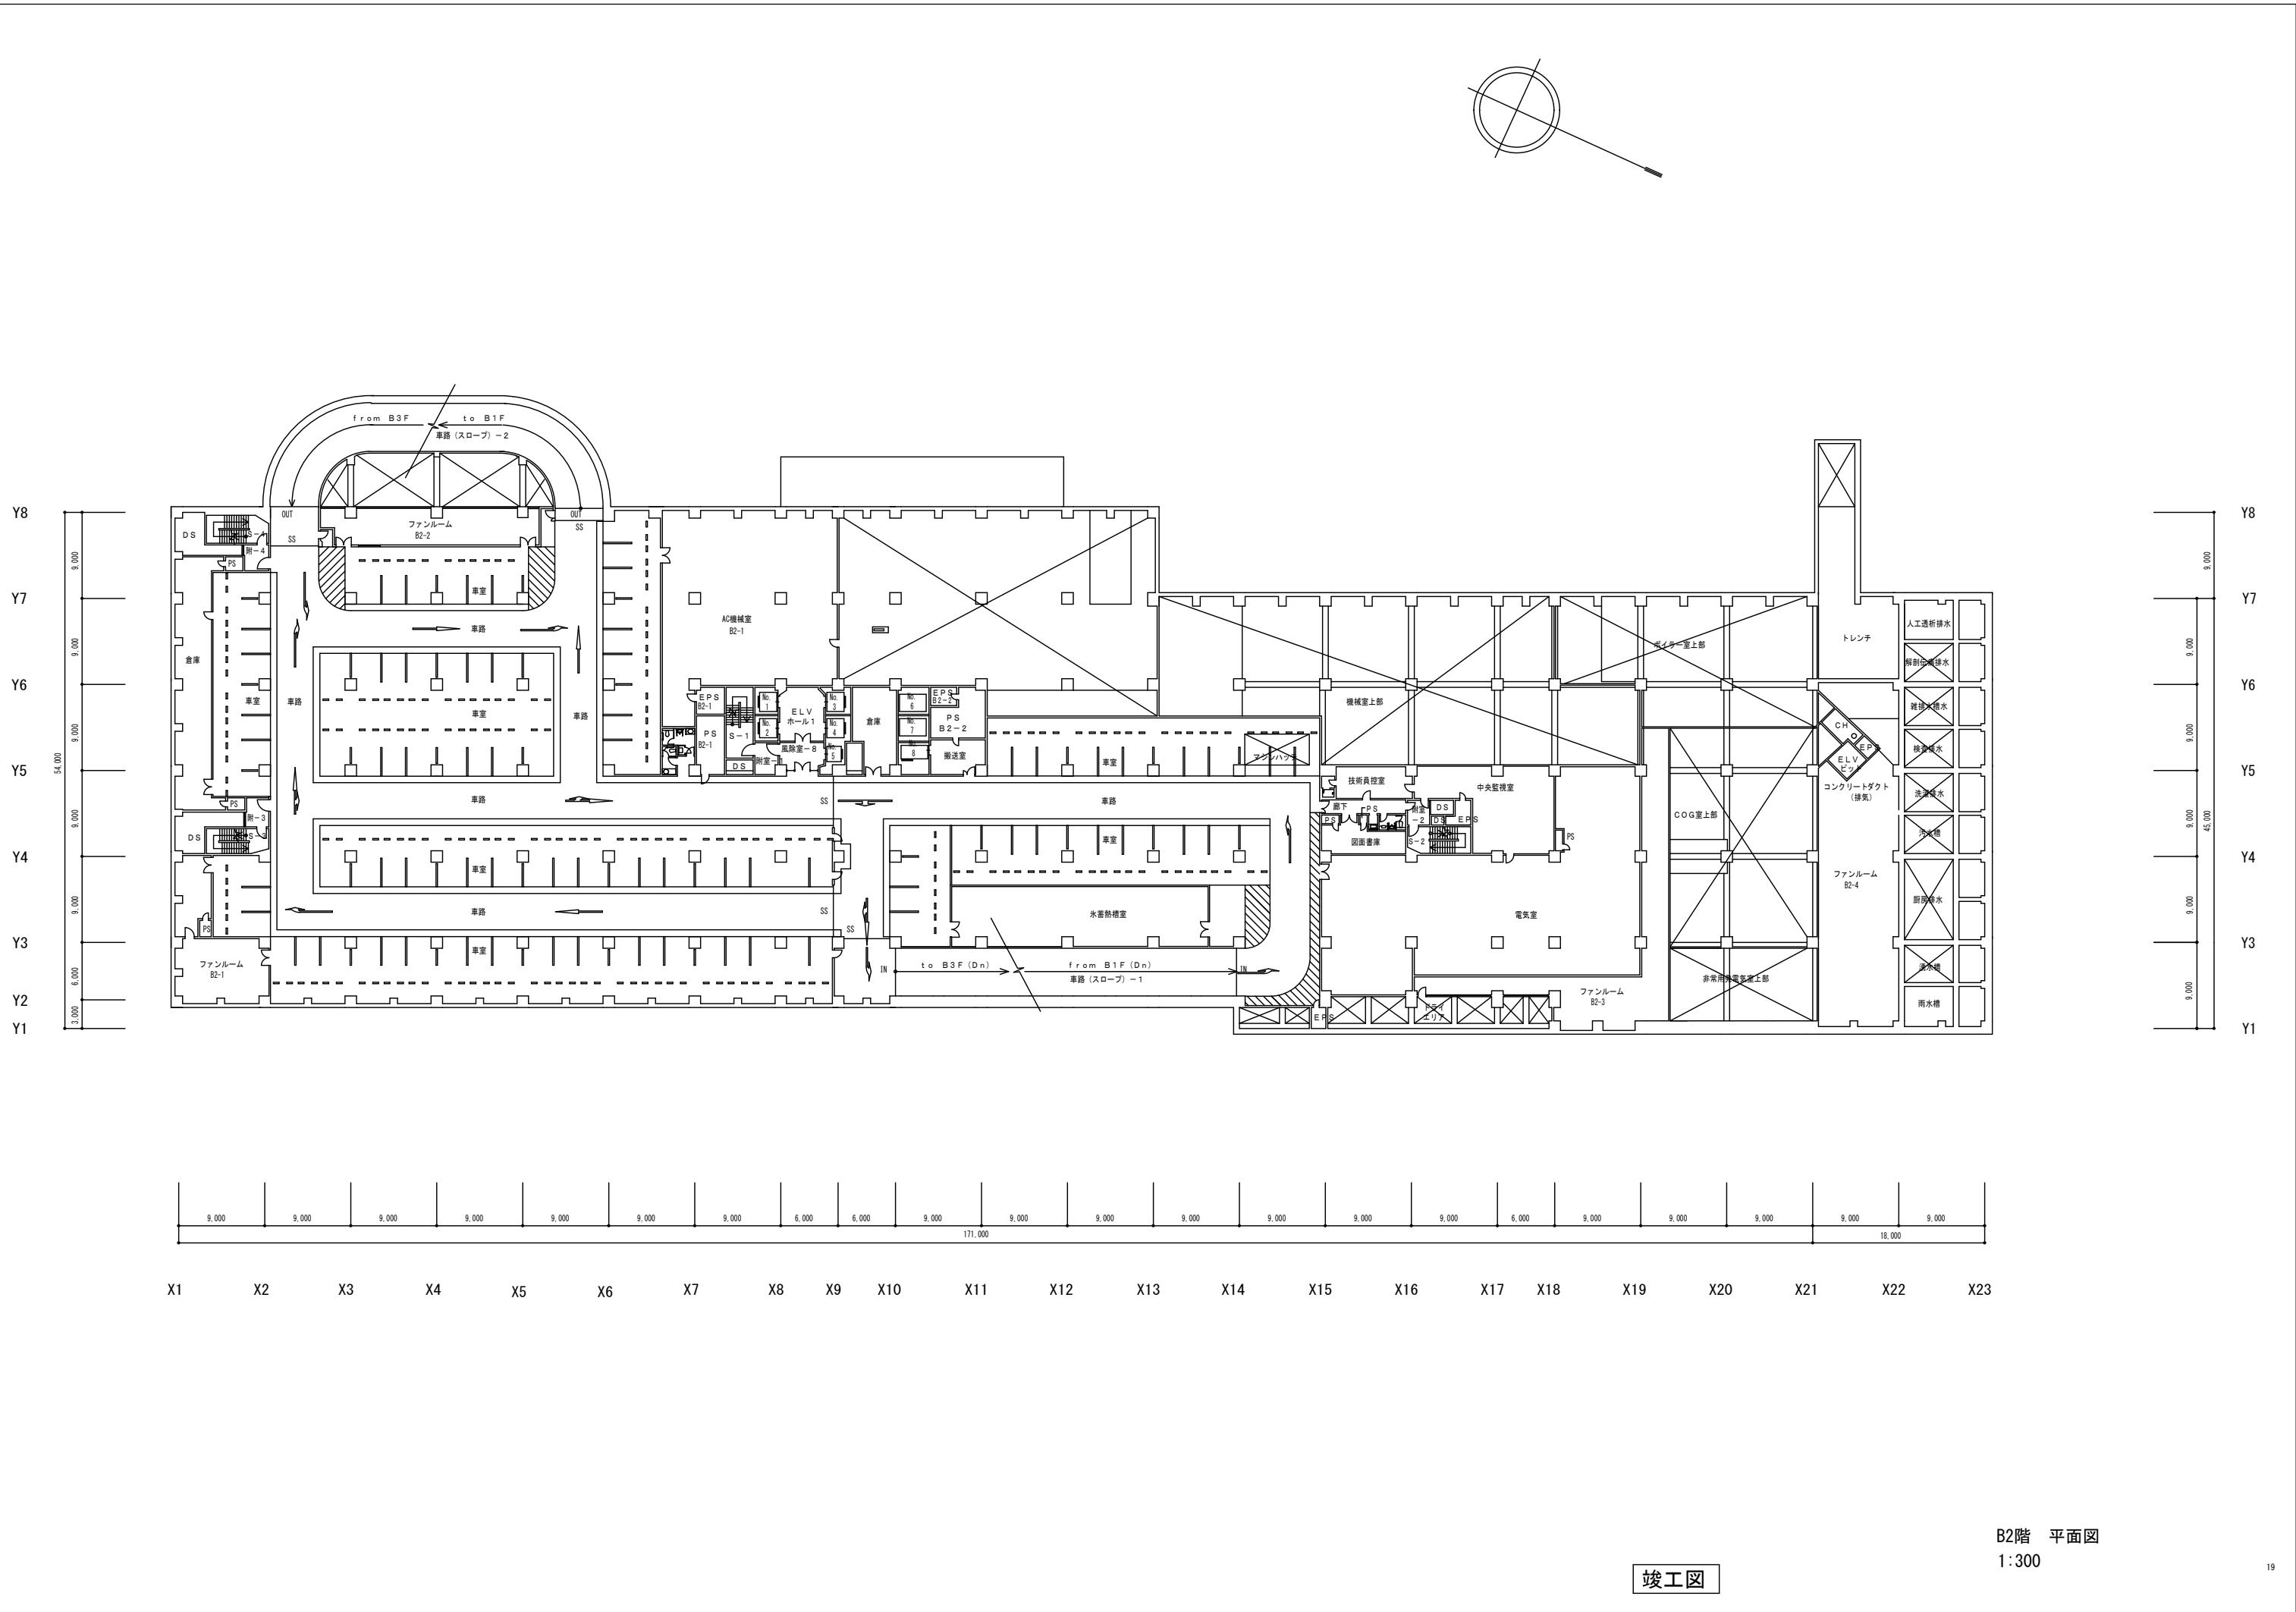


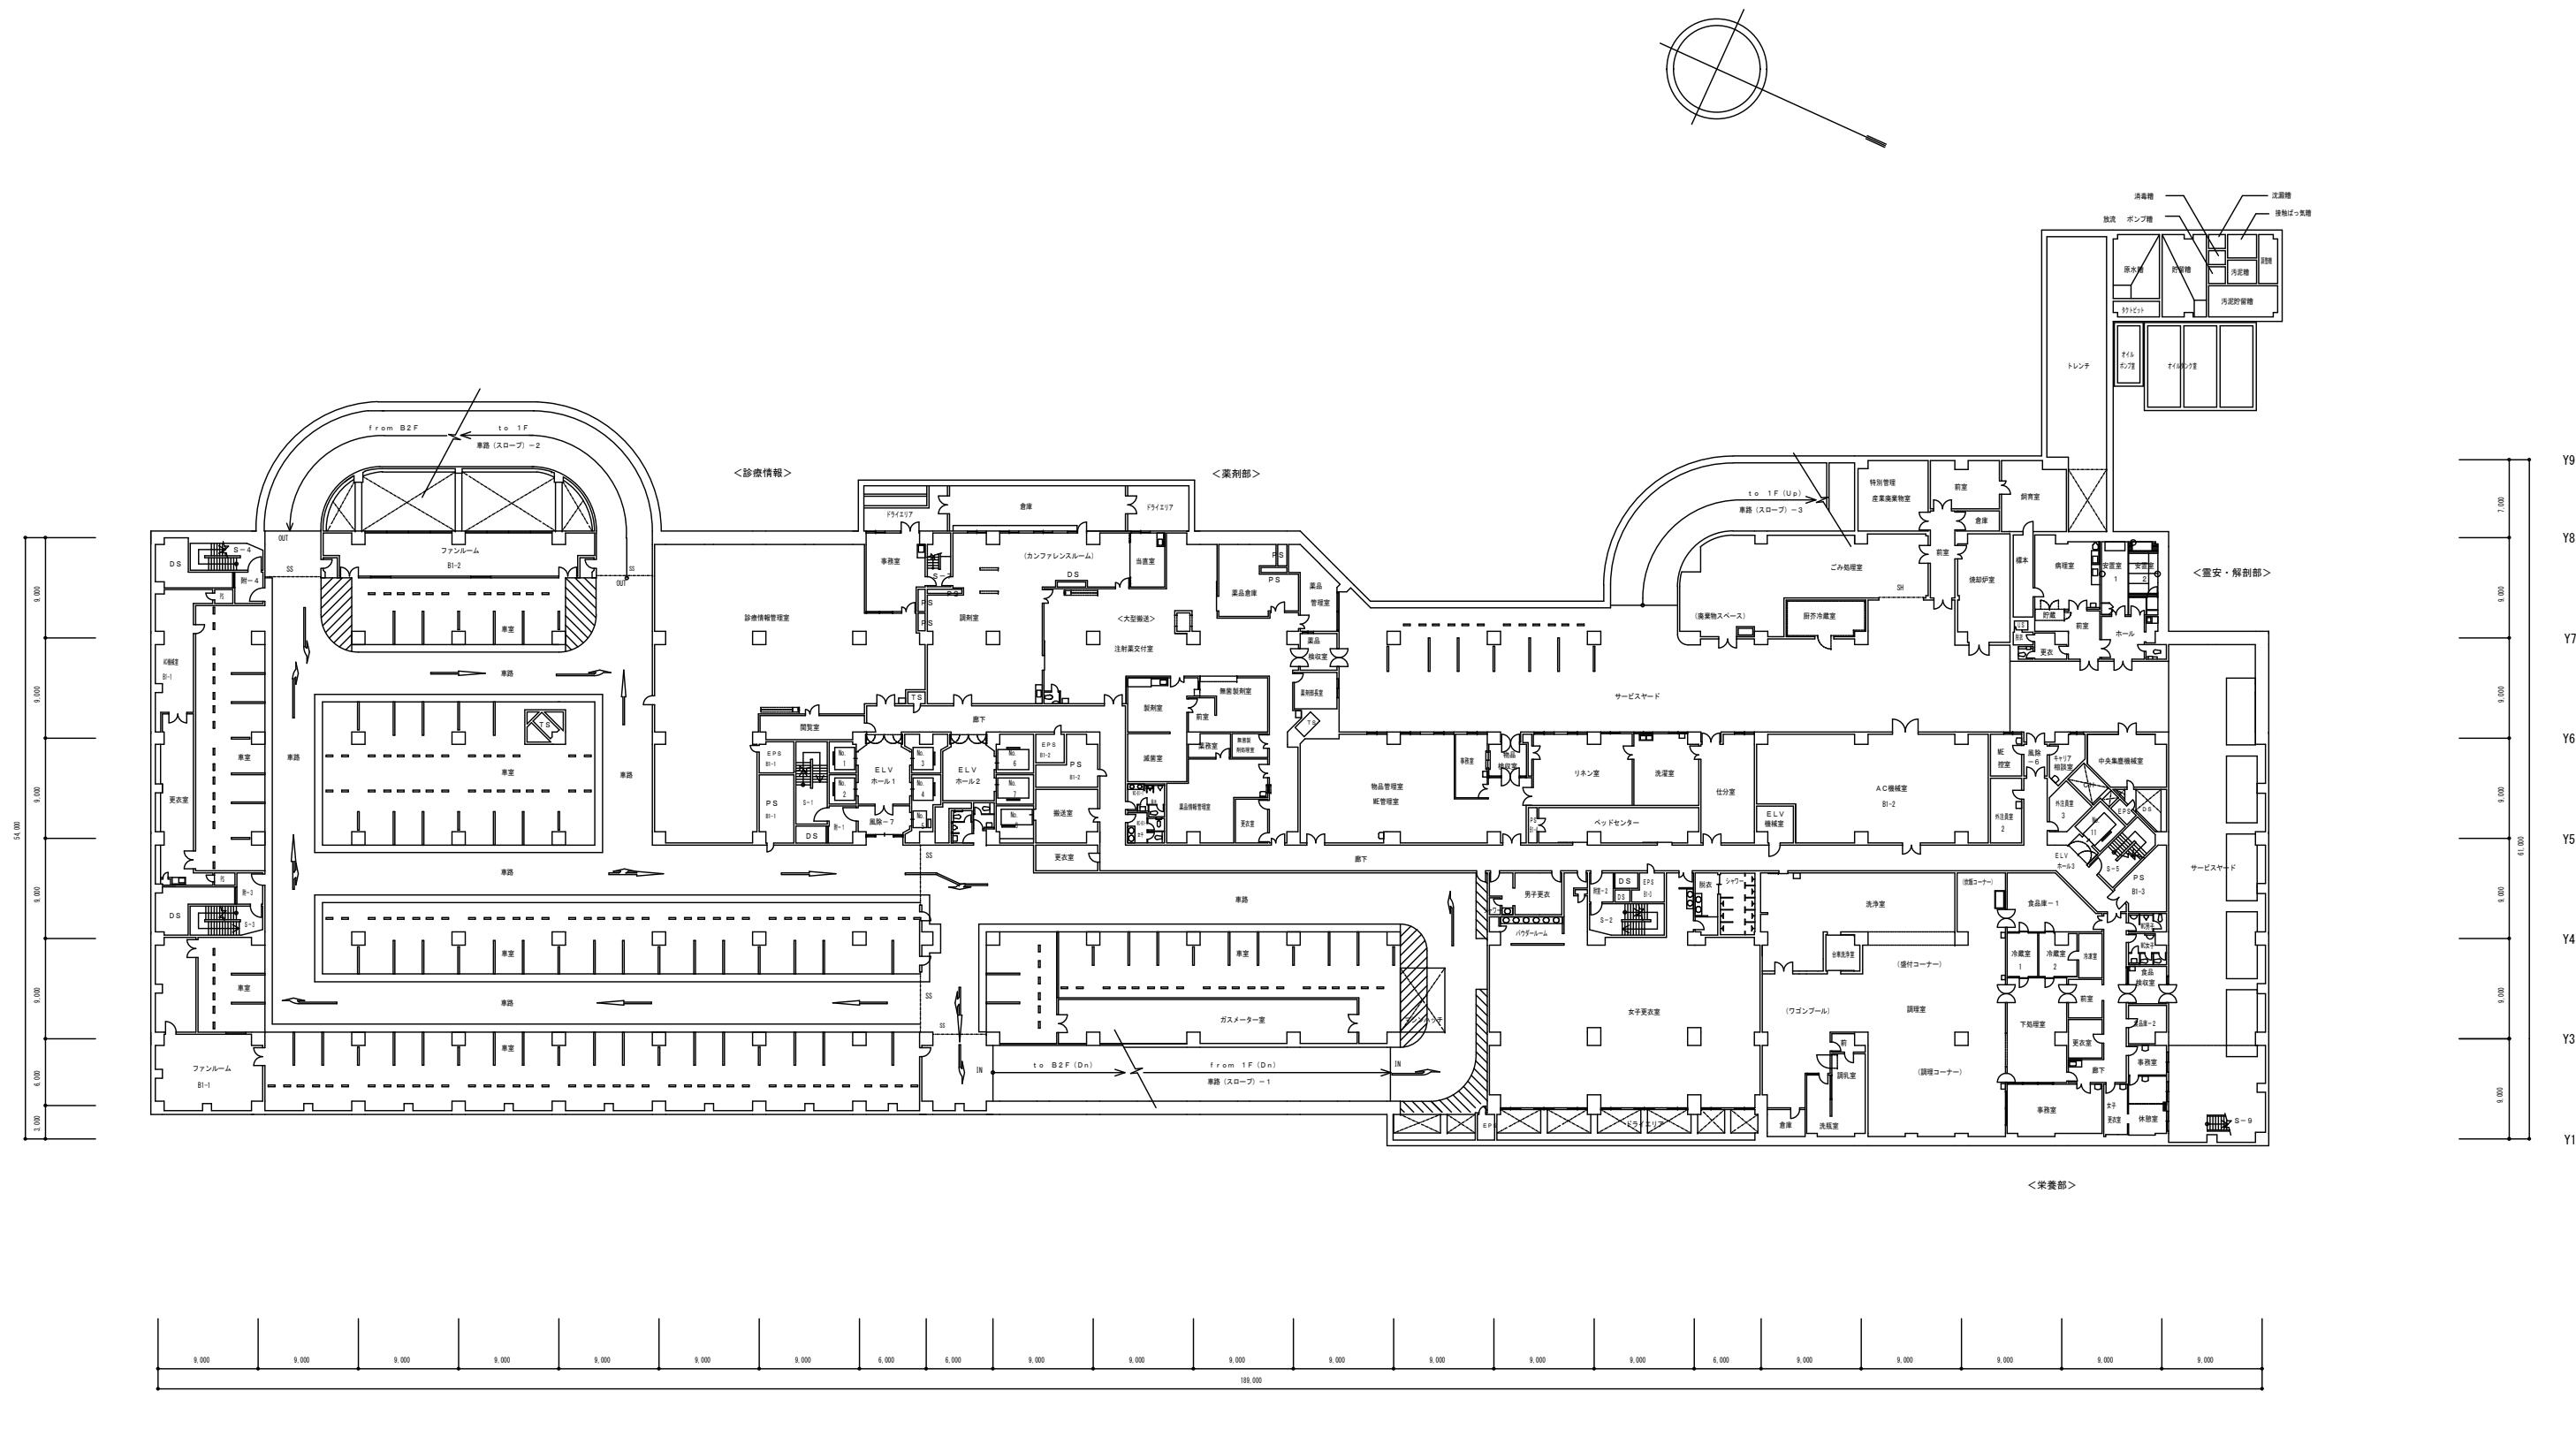


B1階 平面図
1:300



竣工図

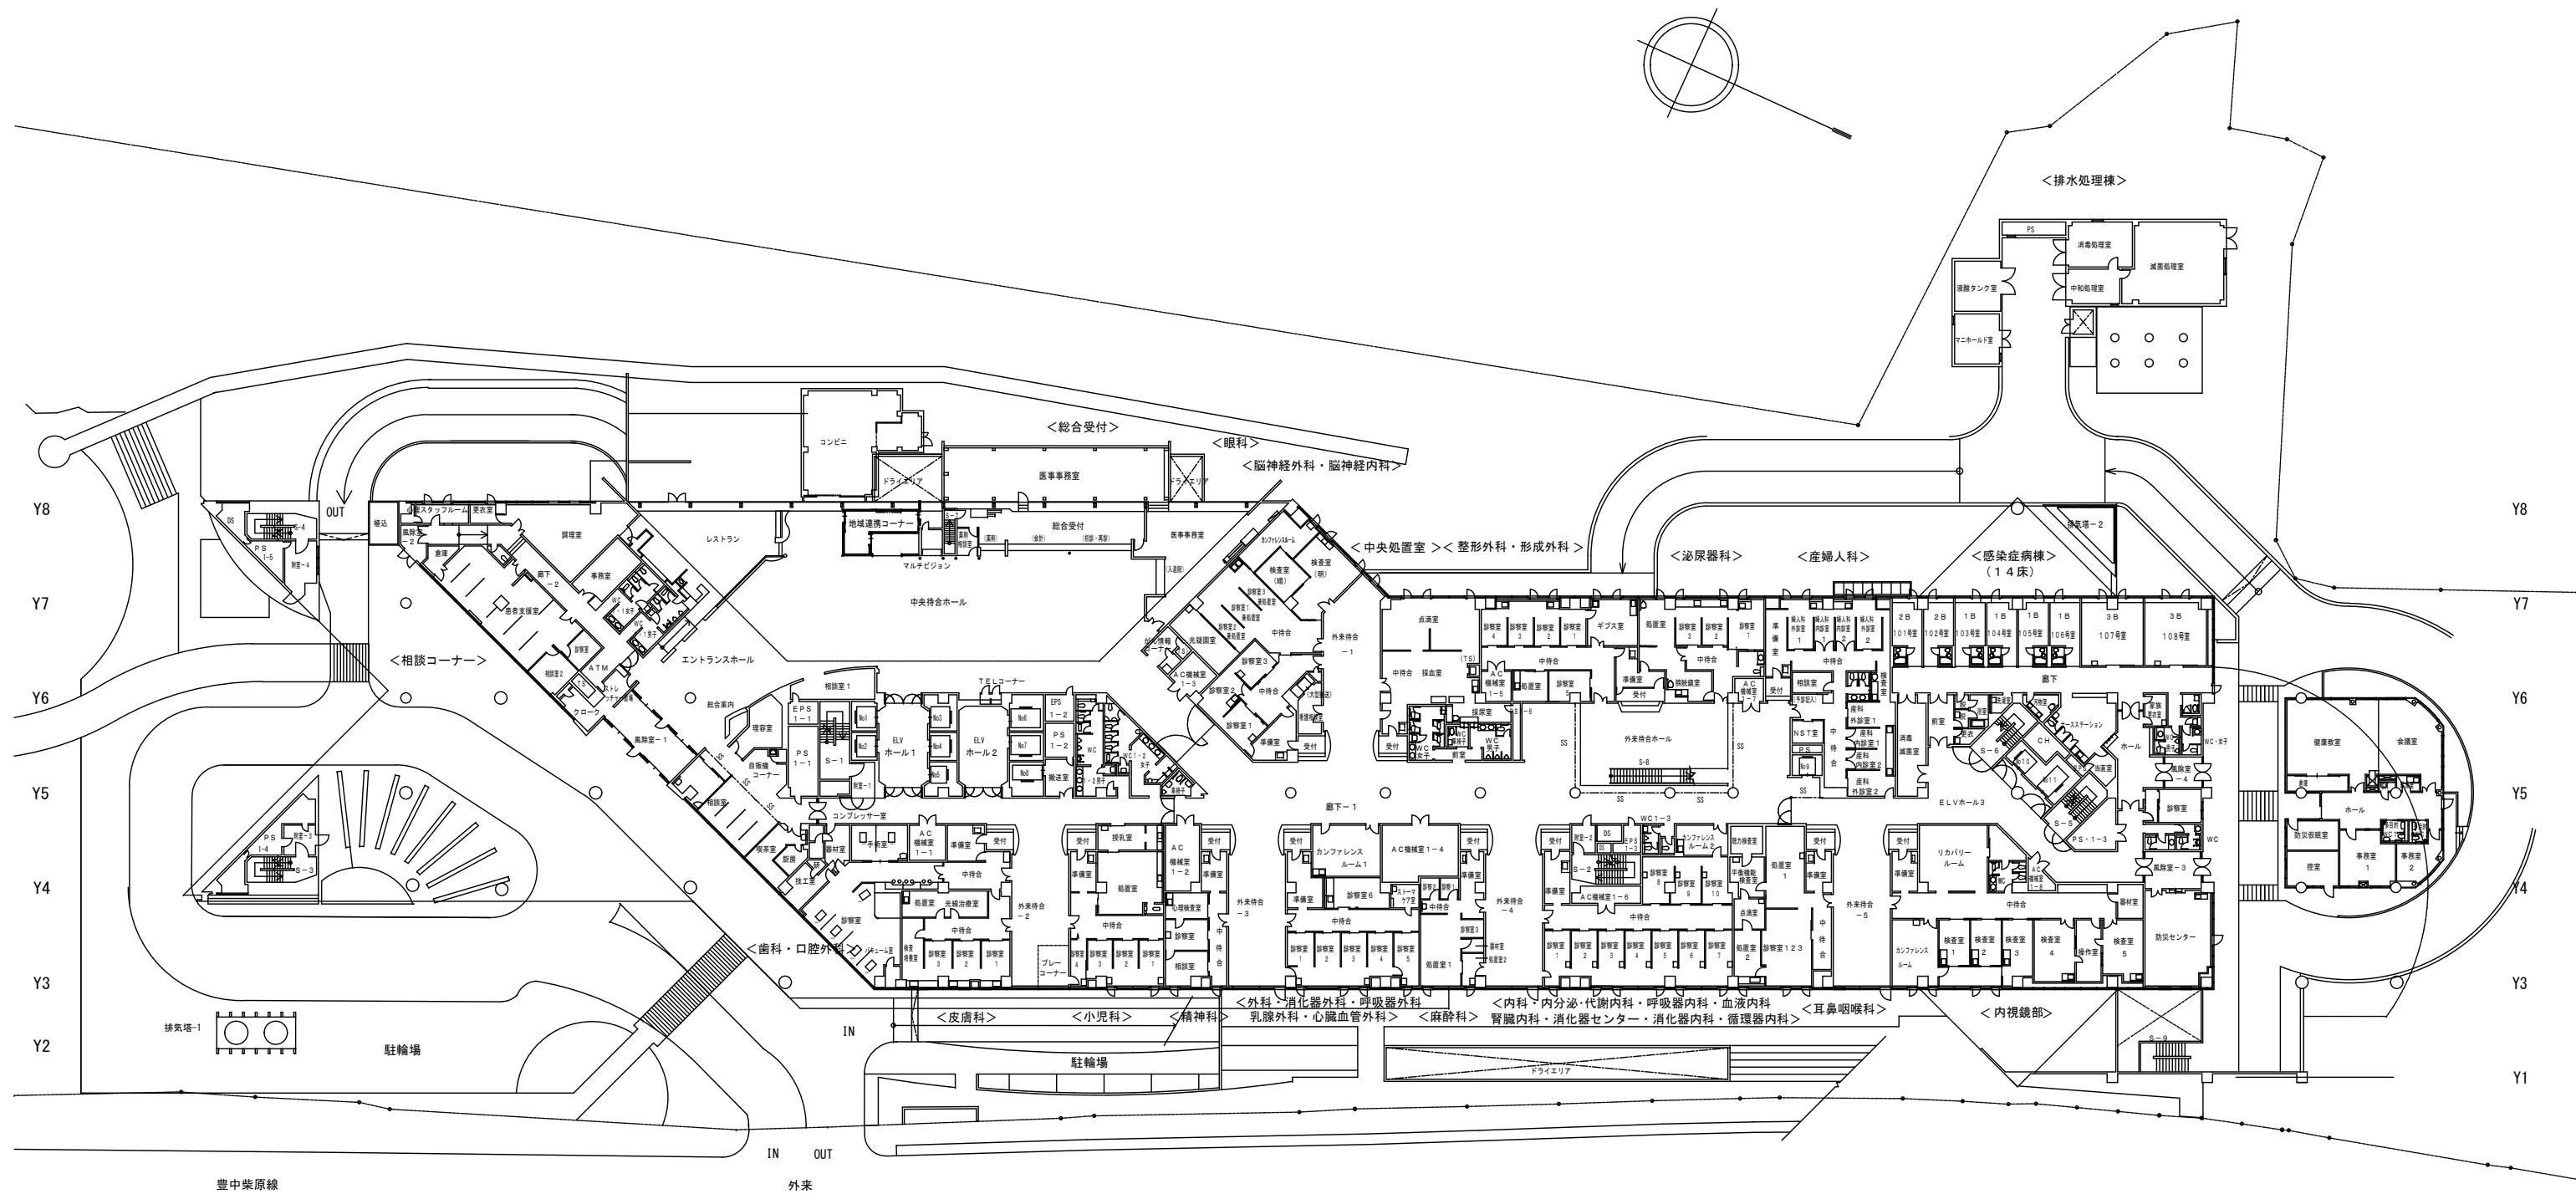

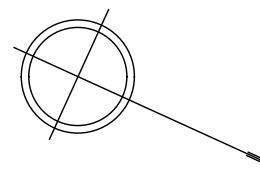


〈中央滅菌部〉

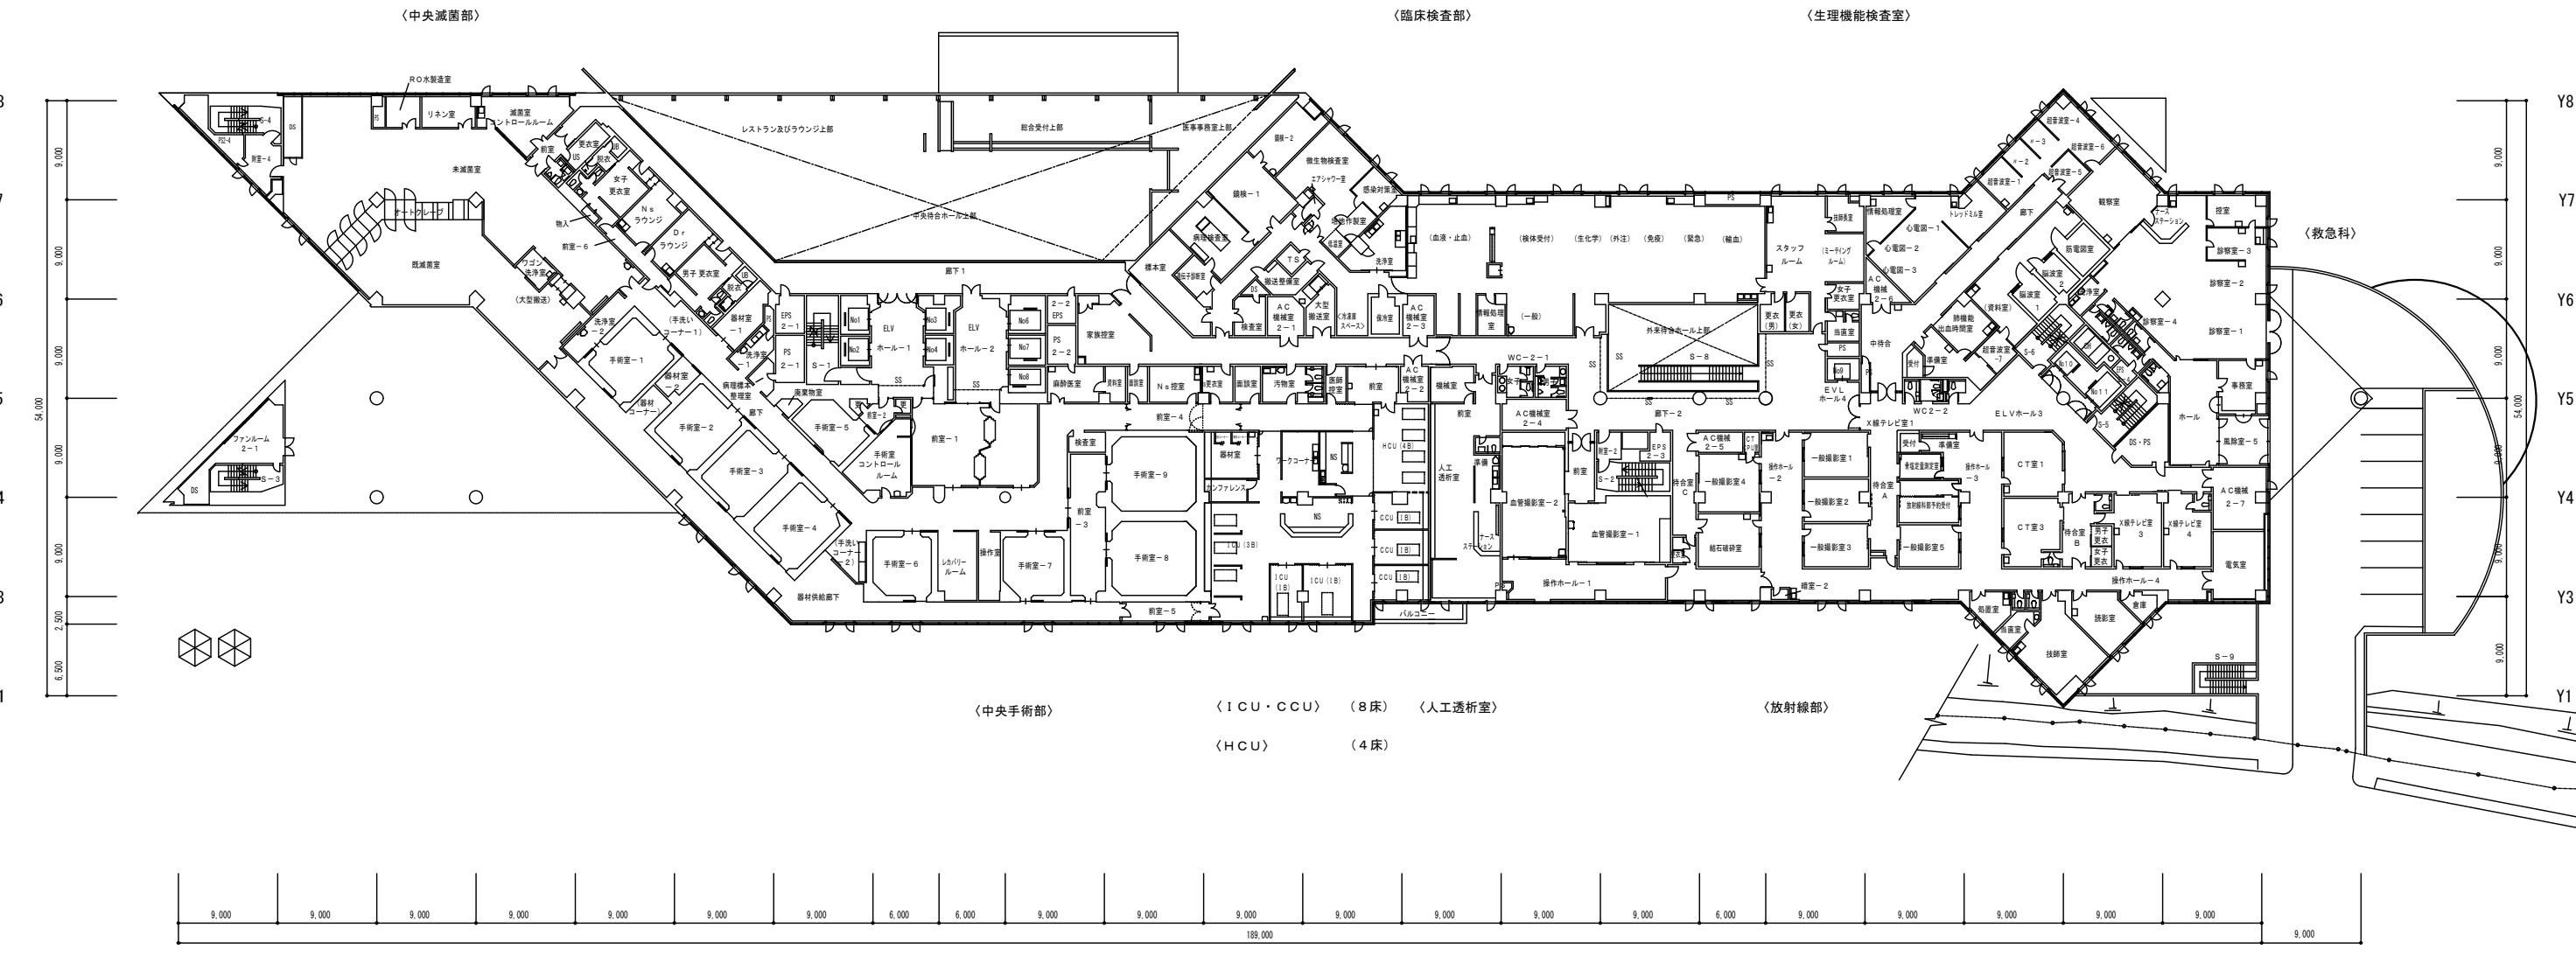

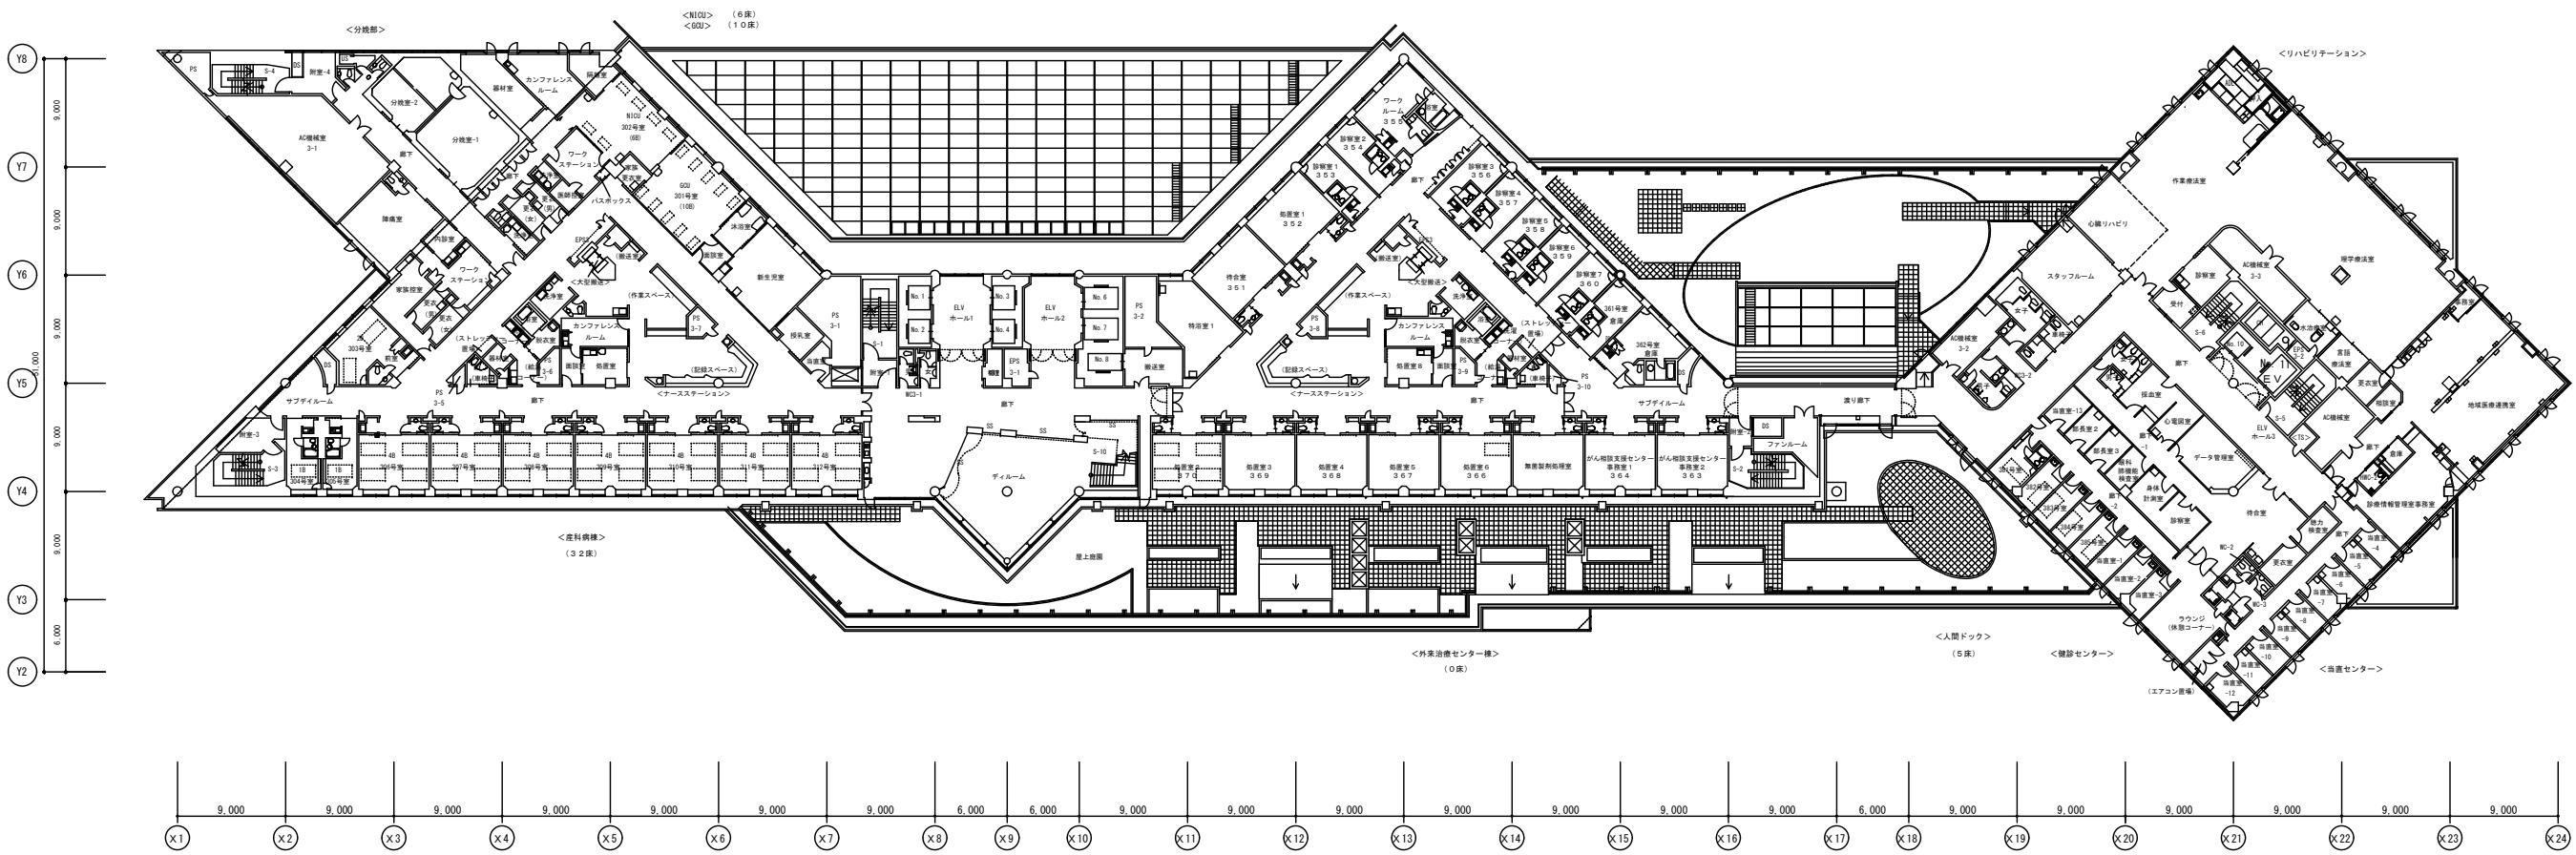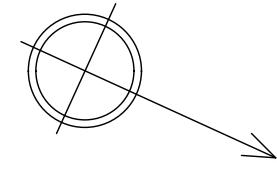


3階平面図



1 : 300

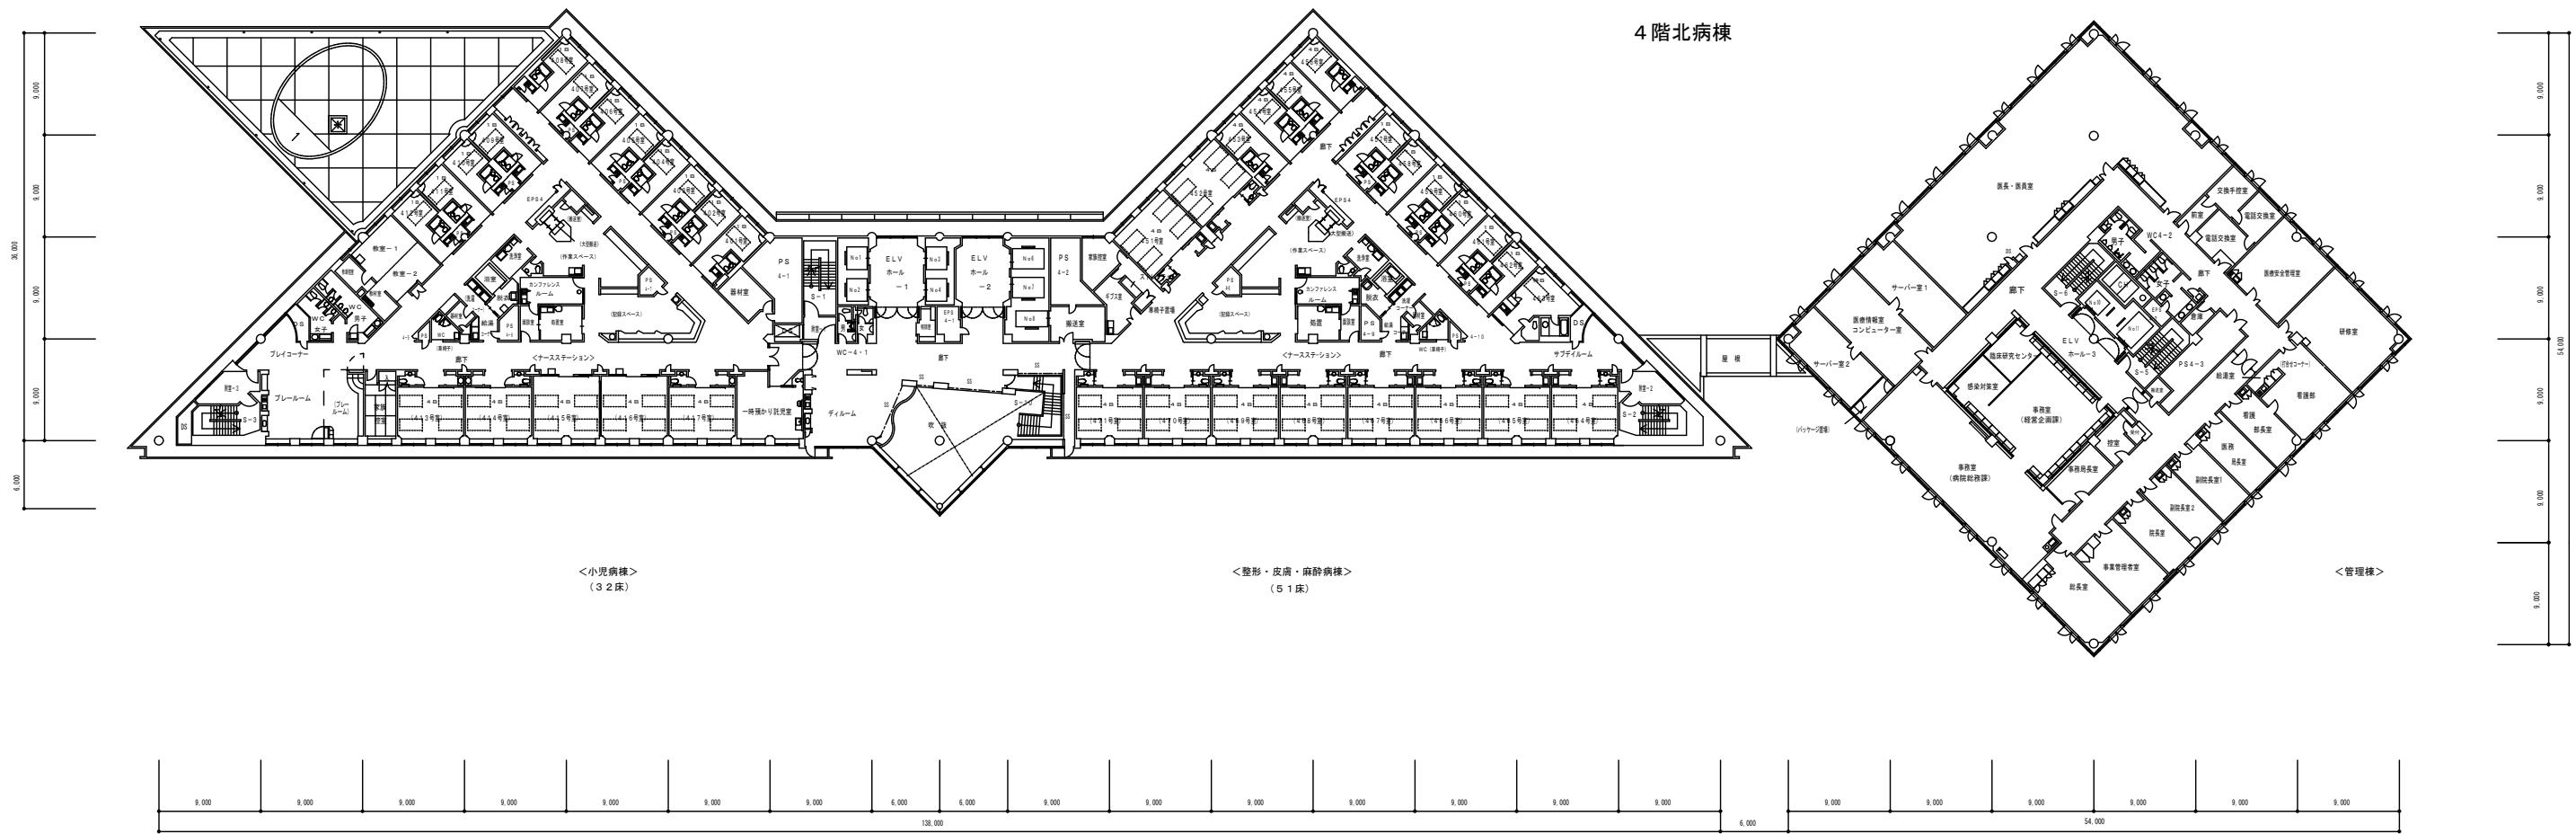

4階 平面図 1:300


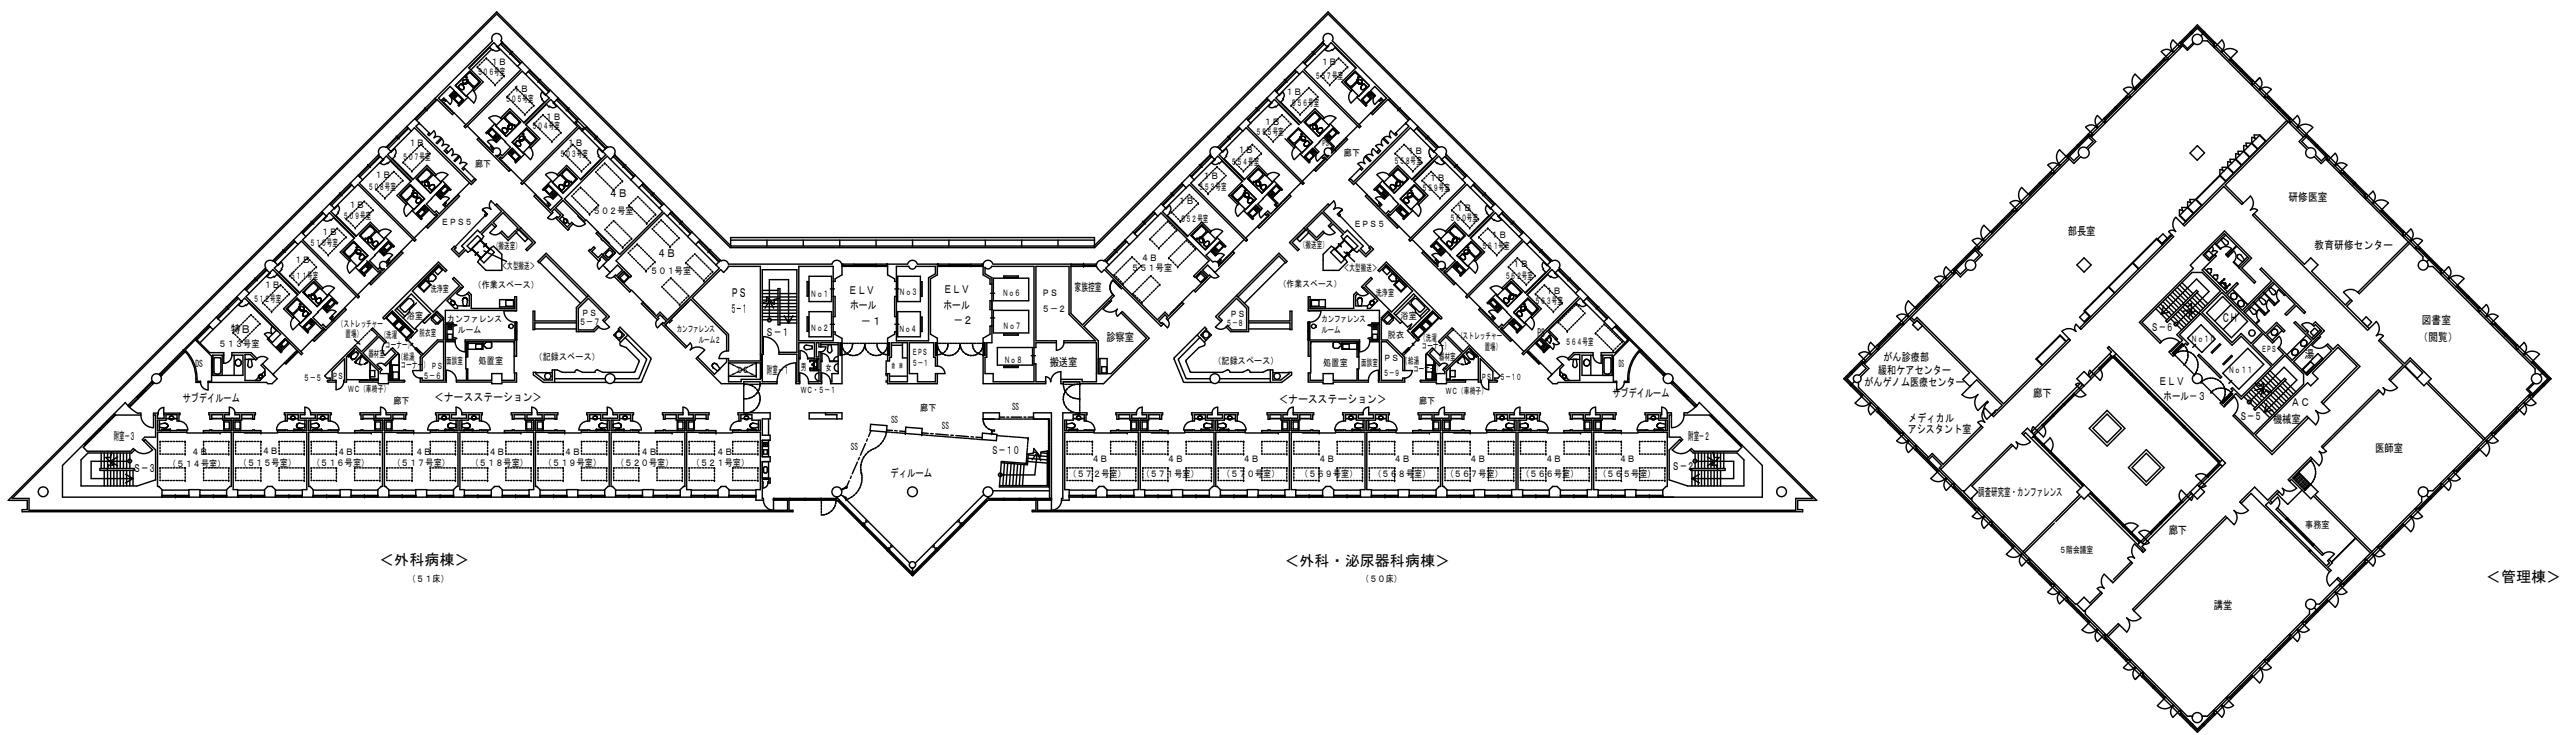


5階 平面図
1:300

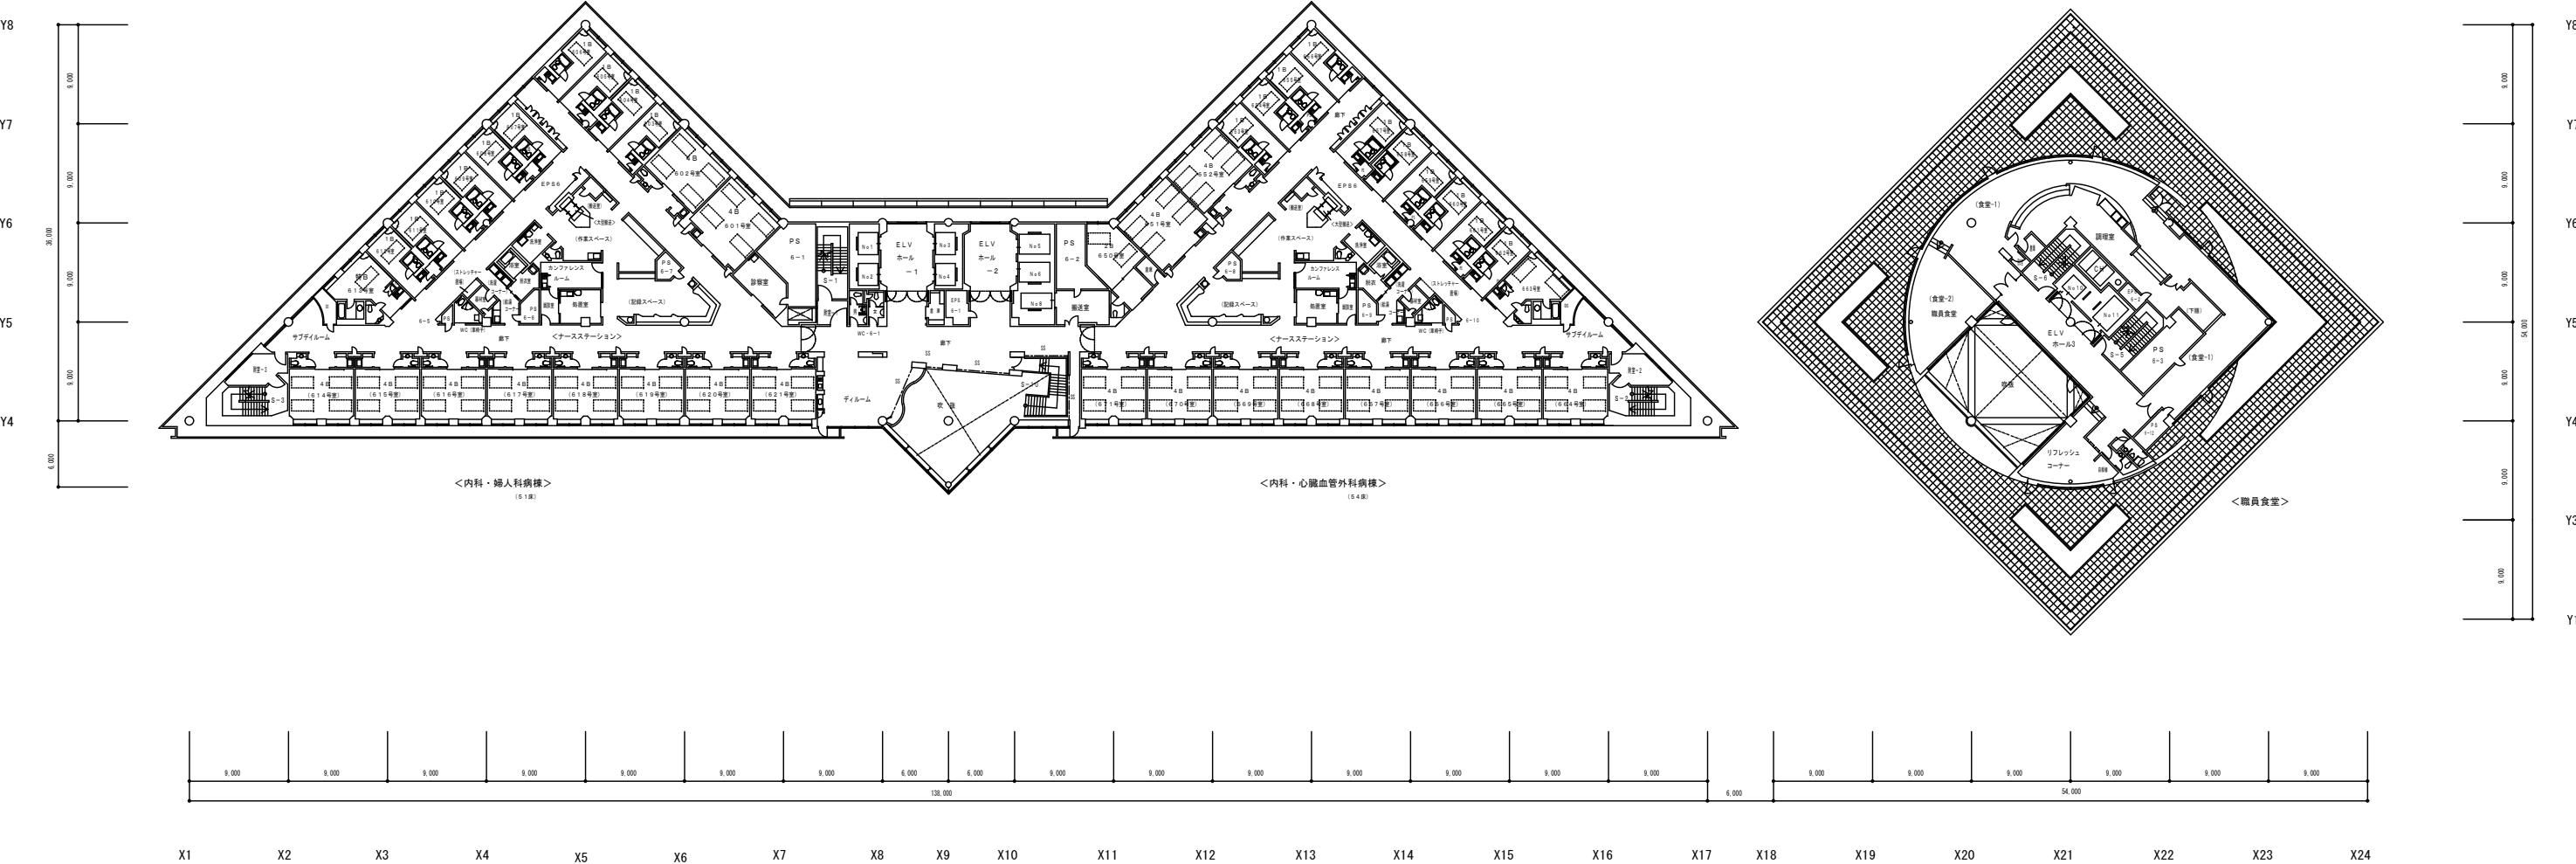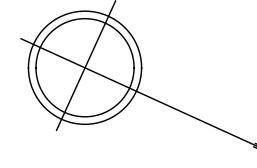


6階 平面図

1:300

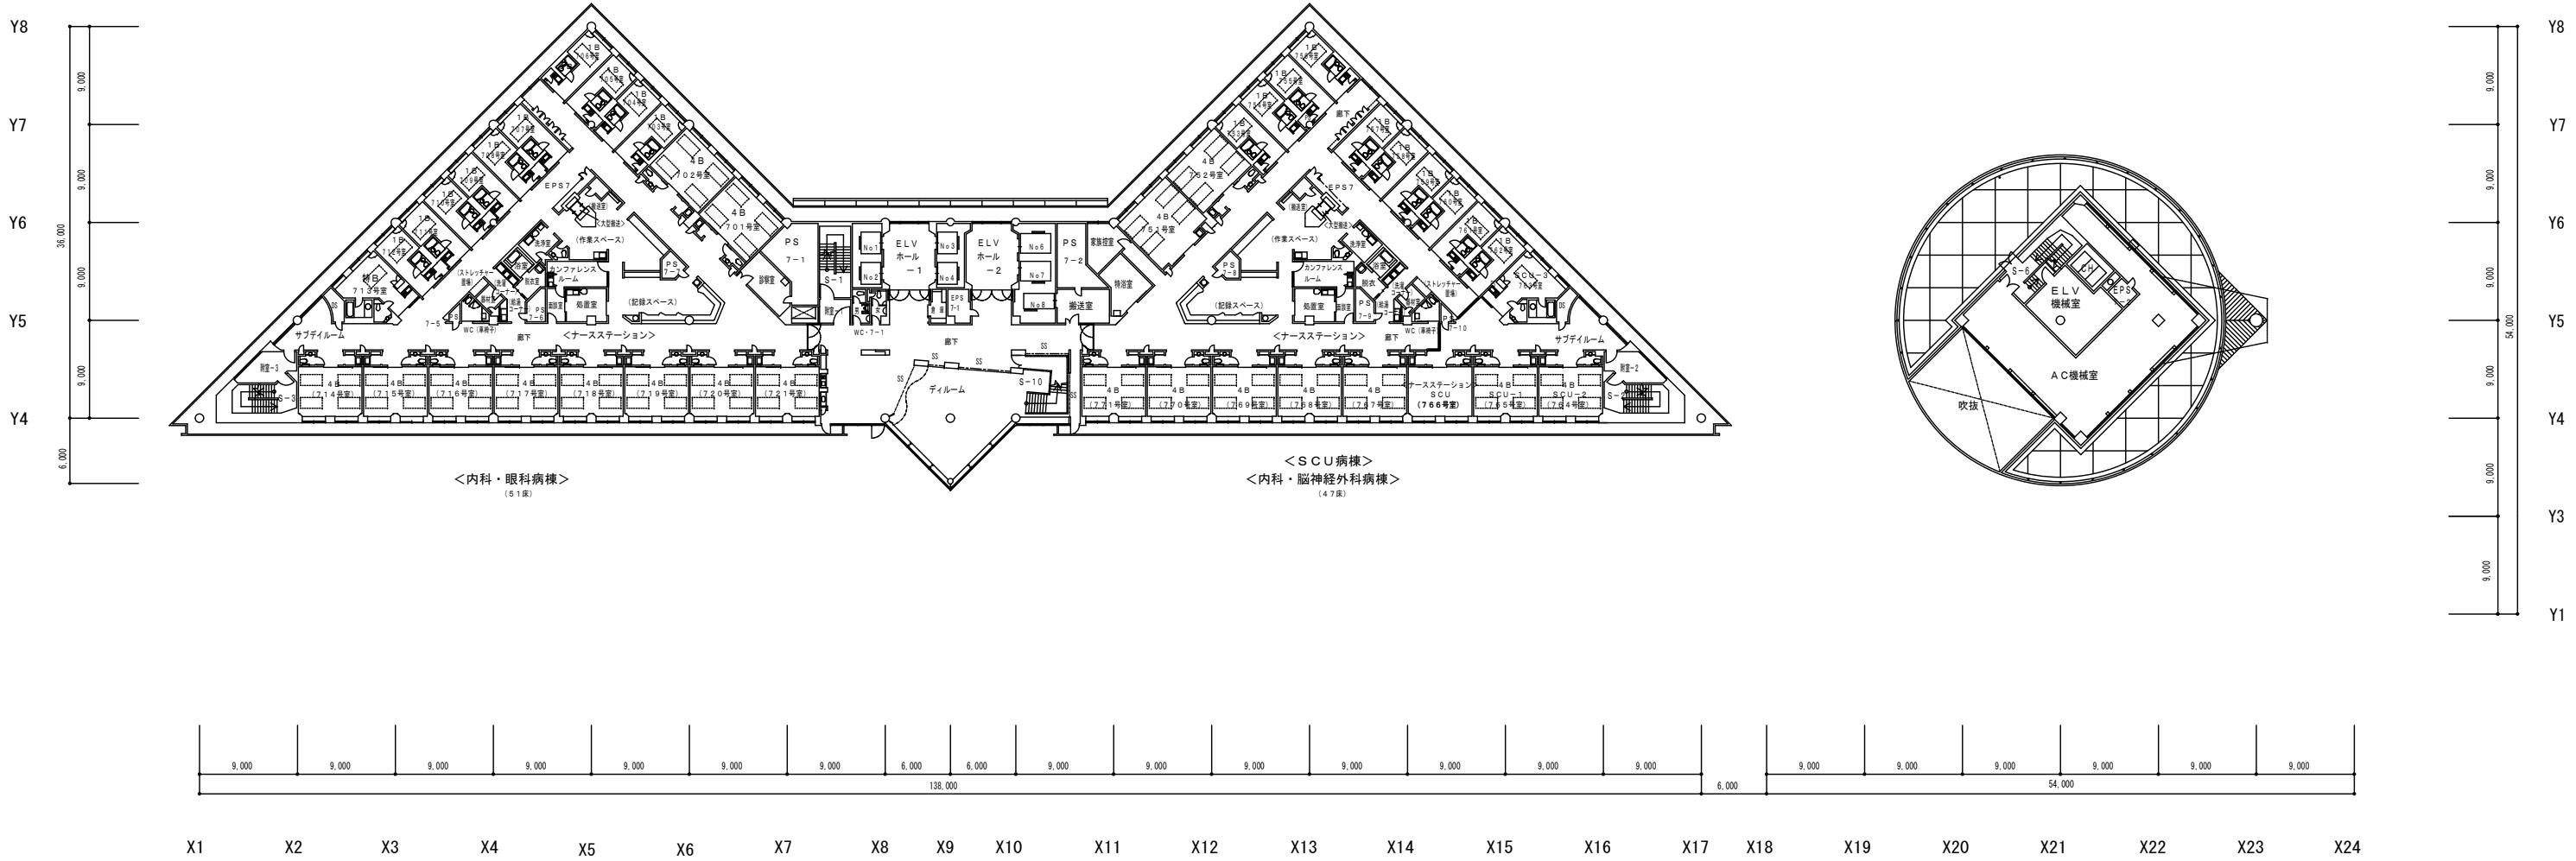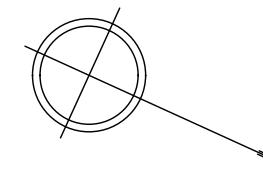


7階 平面図

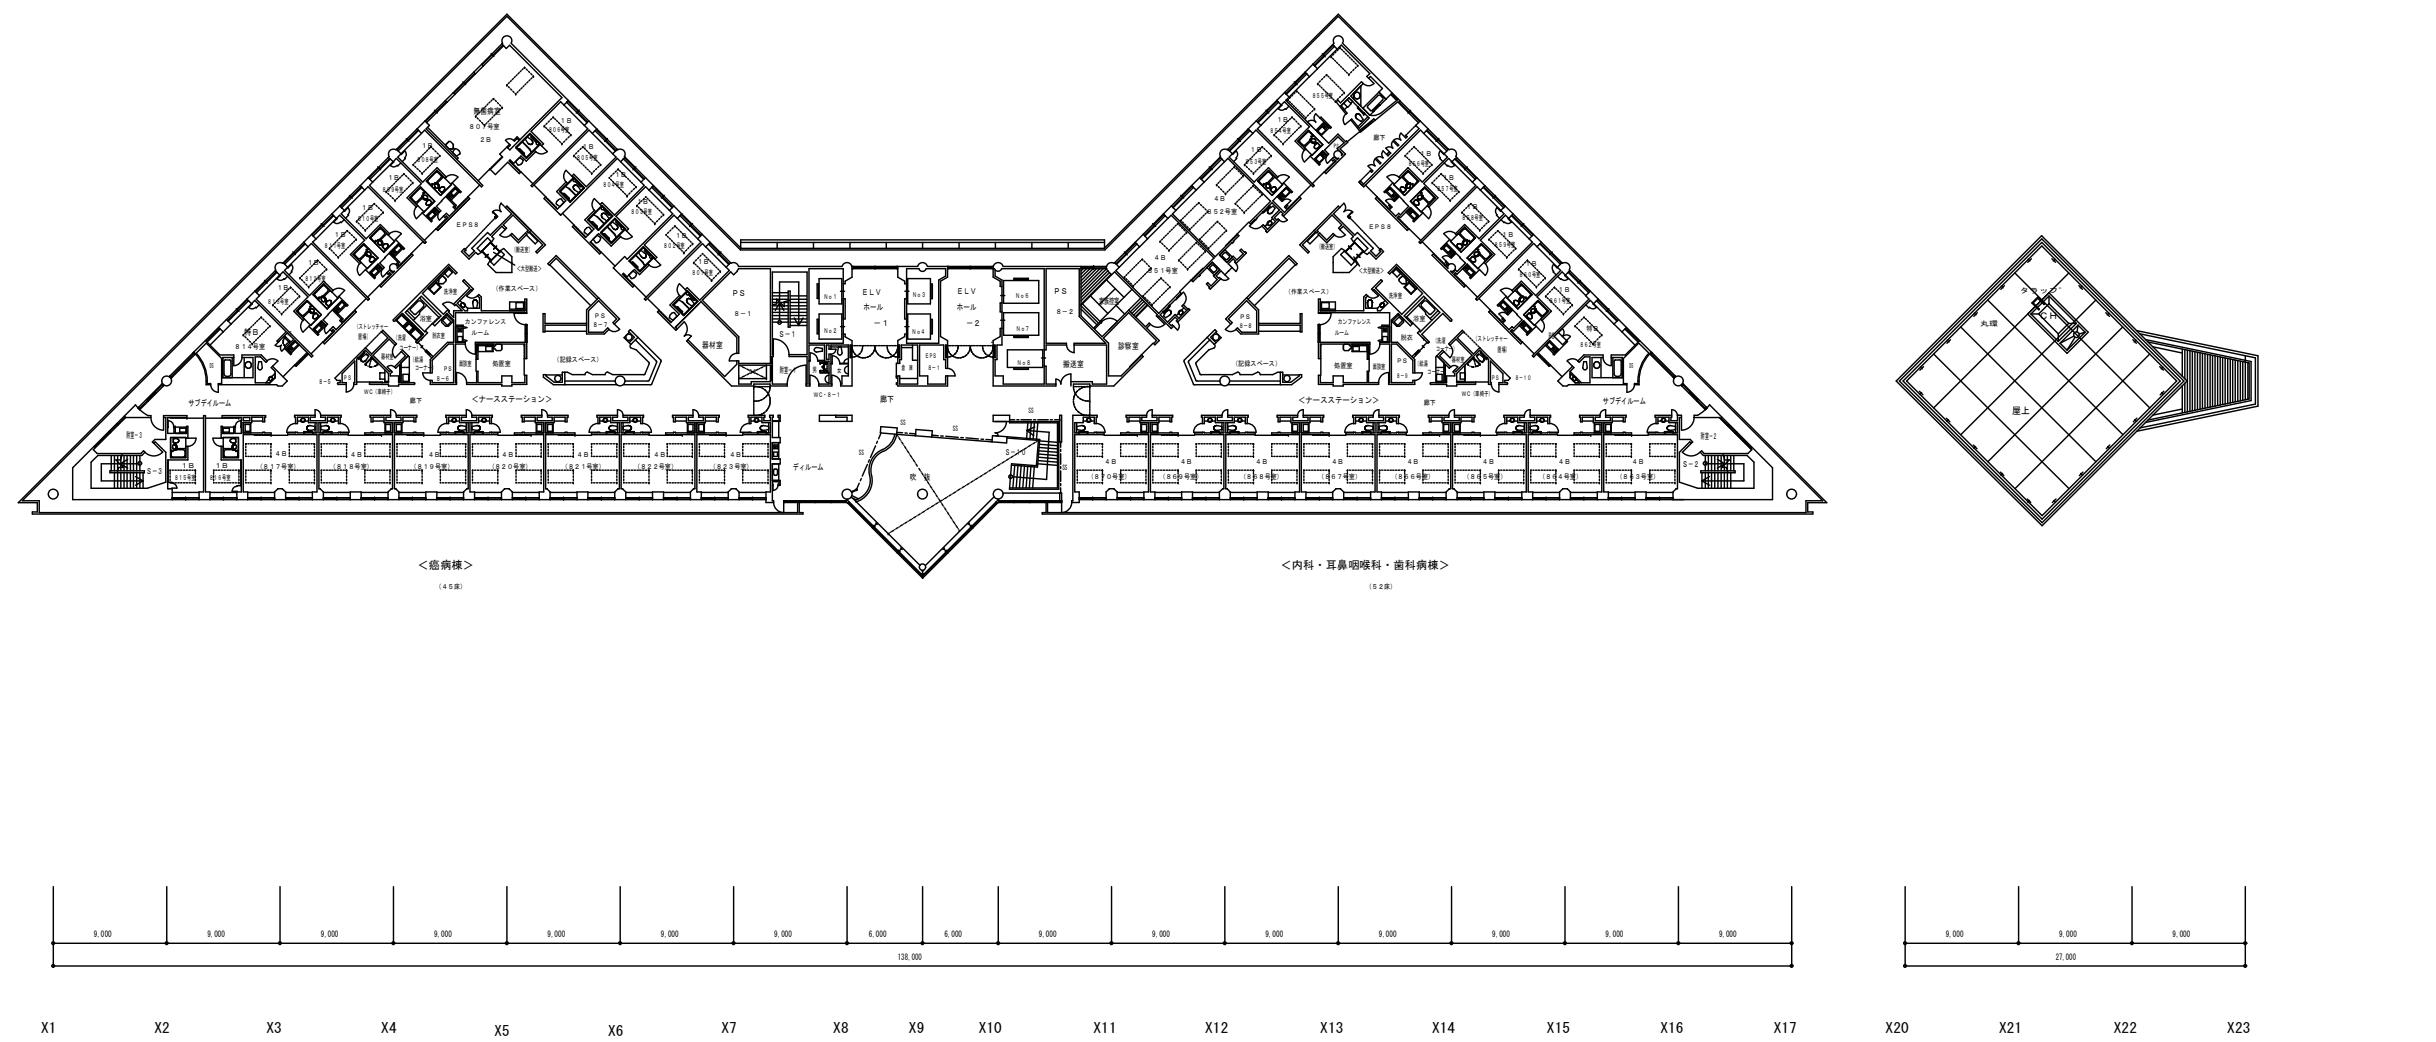


8階 平面図
1:300

竣工図

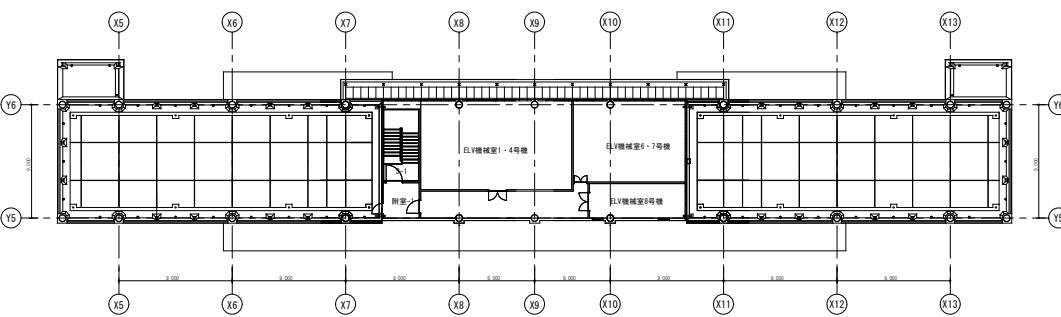

PHF平面図

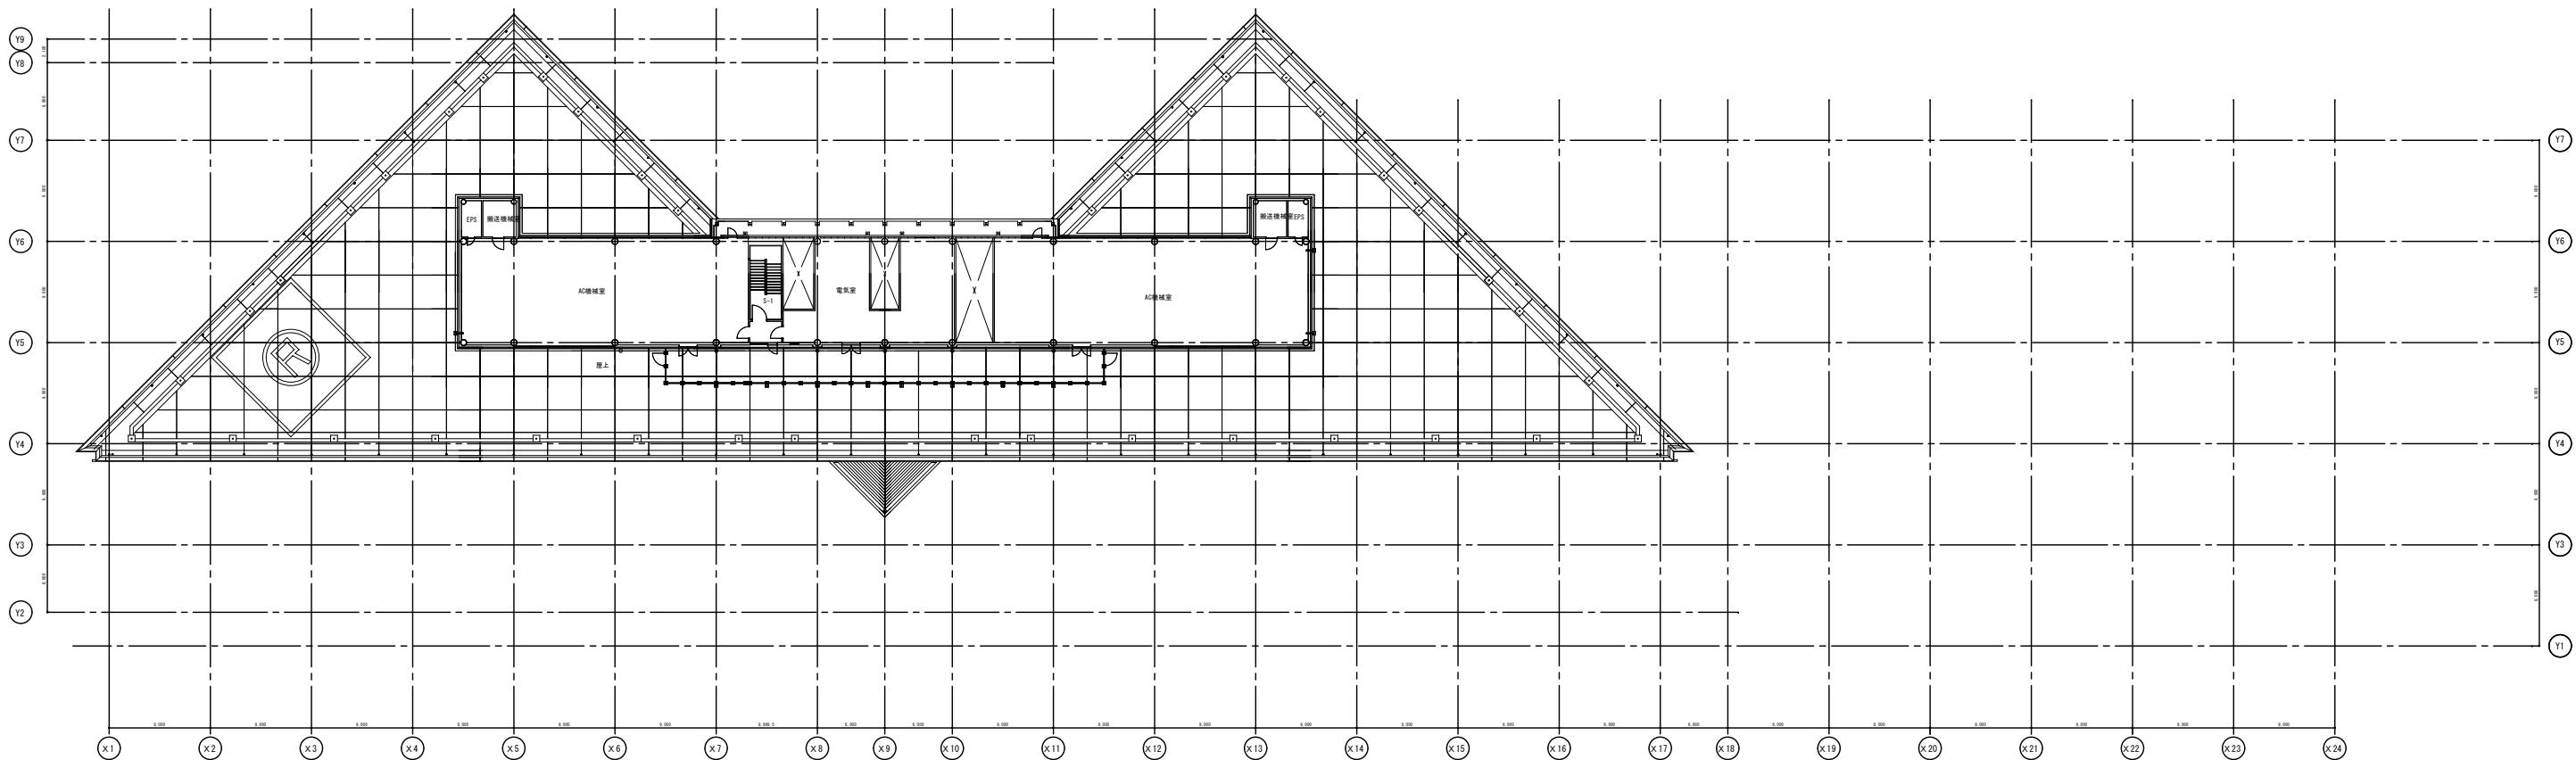

9、PH階 平面図 1/300